GRID LINES AND CO-ORDINATES SHOWN ARE BASED ON WGS-84 DATUM.

DISTANCES IN METRES.
ELEVATIONS IN FEET(EGM-08).
AERODROME ELEVATION 54FT.

AERODROME OBSTACLE CHART
TYPE-B

CHENNAI,INDIA
CHENNAI INTL.AIRPORT

OBST. TABLE FOR RWY 07&25 AND 12&30

S.NO.	UID	FEATURE	LATITUDE	LONGITUDE	TOP.ELEV.IN M.	PERM.ELEV. IN M.	OBST. IN M.	REMARKS	DIST FROM ARP IN M.
1	4001	WDI	12° 59' 38.742" N	080° 11' 01.020" E	22.0	21.6 19.1	0.4 2.9	WITHIN TAKE-OFF APP.30(RWY 12&30) WITHIN T.S.(RWY07&25)	1092
2	4002	WDI	12° 59' 13.583" N	080° 09' 22.239" E	20.3	18.8	1.5	WITHIN T.S.(RWY07&25)	2086
3	4003	WDI	13° 00' 11.172" N	080° 09' 55.952" E	19.8	13.1	6.7	WITHIN STRIP(RWY 12&30)	1244
4	4004	WDI	12° 59' 43.940" N	080° 10' 34.770" E	18.3	12.4	5.9	WITHIN STRIP(RWY 12&30)	299
~~5~~	~~4008~~	~~LLZ MONITOR ANTENNA~~	~~12° 59' 01.108" N~~	~~080° 09' 05.754" E~~	~~14.6~~	~~14.1~~	~~0.6~~	~~WITHIN TAKE-OFF APP.07(RWY07&25)~~	~~2702~~
~~6~~	~~4010~~	~~LLZ ANTENNA~~	~~12° 59' 00.325" N~~	~~080° 09' 03.543" E~~	~~15.5~~	~~13.5~~	~~2.0~~	~~WITHIN TAKE-OFF APP.07(RWY07&25)~~	~~2772~~
7	4011	GP ANTENNA	12° 59' 10.737" N	080° 09' 20.094" E	27.9	13.1	14.8	WITHIN STRIP(RWY07&25)	2183
8	4012	DVOR MONITOR ANTENNA	12° 59' 10.783" N	080° 09' 20.095" E	22.7	13.1	9.6	WITHIN STRIP(RWY07&25)	2182
~~9~~	~~4025~~	~~GP ANTENNA~~	~~12° 59' 45.287" N~~	~~080° 10' 53.796" E~~	~~30.5~~	~~23.7~~ ~~15.6~~	~~6.9~~ ~~14.9~~	~~WITHIN T.S.(RWY 12&30)~~ ~~WITHIN STRIP(RWY07&25)~~	~~873~~
~~10~~	~~4026~~	~~GP MONITOR ANTENNA~~	~~12° 59' 46.316" N~~	~~080° 10' 56.338" E~~	~~19.6~~	~~15.8~~	~~3.8~~	~~WITHIN STRIP(RWY07&25)~~	~~953~~
11	4027	GP MONIITOR ANTENNA	12° 59' 09.803" N	080° 09' 17.568" E	17.2	13.1	4.1	WITHIN STRIP(RWY07&25)	2264
~~12~~	~~4030~~	~~GP DME ANTENNA~~	~~12° 59' 45.114" N~~	~~080° 10' 53.814" E~~	~~19.1~~	~~15.6~~	~~3.5~~	~~WITHIN STRIP(RWY07&25)~~	~~873~~
13	4031	GP DME ANTENNA	12° 59' 10.874" N	080° 09' 19.998" E	17.5	13.1	4.4	WITHIN STRIP(RWY07&25)	2183
14	4130	APPROACH LIGHT	12° 59' 02.590" N	080° 09' 09.680" E	13.3	13.1	0.2	WITHIN STRIP(RWY07&25)	2576
15	4131	APPROACH LIGHT	12° 59' 02.250" N	080° 09' 08.770" E	13.3	13.1	0.2	WITHIN STRIP(RWY07&25)	2606
16	5702	AIRPORT BOUNDARY WALL WITH FENCING ON TOP	13° 00' 27.570" N	080° 09' 20.810" E	15.6	13.0	2.6	WITHIN TAKE-OFF APP.12(RWY 12&30)	2380
17	6086	MET INSTRUMENT ANTENNA	12° 59' 46.340" N	080° 10' 42.810" E	18.3	13.6	4.7	WITHIN STRIP(RWY 12&30)	551
18	6140	CIWS ANTENNA	13° 00' 19.971" N	080° 09' 39.798" E	23.1	13.2	9.9	WITHIN STRIP(RWY 12&30)	1785
19	6174	ANTENNA ON BUILDING TOP	12° 59' 14.770" N	080° 10' 11.330" E	45.4	38.2	7.2	WITHIN T.S.(RWY07&25)	942
20	6288	SINTEX TANK ON BUILDING TOP	12° 58' 57.448" N	080° 08' 45.871" E	27.2	24.1	3.1	WITHIN TAKE-OFF APP.07(RWY07&25)	3289
21	6296	BUILDING	12° 59' 26.960" N	080° 11' 02.010" E	28.6	25.5	3.1	WITHIN APP.30(RWY 12&30)	1212
22	6316	LIGHTNING ARRESTOR ON OSIAN CHLOROPHY 1(LIGHTED TOP - 69.1 M, BUILDING TOP - 67.2 M)	13° 02' 19.073" N	080° 08' 53.054" E	69.2	61.5	7.7	WITHIN I.H.S.(RWY 12&30) WITHIN I.H.S.(RWY07&25)	5554
23	6350	LIGHTNING ARRESTOR ON OSIAN CHLOROPHY 2 (LIGHTED TOP - 69.4 M, BUILDING TOP - 66.9 M)	13° 02' 16.873" N	080° 08' 53.346" E	69.2	61.5	7.7	WITHIN I.H.S.(RWY 12&30) WITHIN I.H.S.(RWY07&25)	5491
24	6479	LIGHTNING ARRESTOR ON SKYPARK RESIDENCE (BUILDING TOP - 72.8 M)	12° 57' 19.626" N	080° 09' 06.722" E	77.1	61.5	15.6	WITHIN I.H.S.(RWY 12&30) WITHIN I.H.S.(RWY07&25)	4979
25	6507	BUILDING	12° 59' 00.096" N	080° 08' 46.278" E	25.8	25.0	0.8	WITHIN APP.07(RWY07&25)	3244
~~26~~	~~6920~~	~~SHED~~	~~12° 59' 32.400" N~~	~~080° 10' 54.836" E~~	~~20.3~~	~~20.1~~	~~0.2~~	~~WITHIN APP.30(RWY 12&30)~~	~~950~~
27	6930	BUILDING	12° 59' 29.006" N	080° 10' 55.989" E	31.0	23.8	7.2	WITHIN T.S.(RWY 12&30)	1020
28	6970	HILL TOP	13° 00' 06.720" N	080° 11' 27.880" E	46.3	45.6	0.7	WITHIN T.S.(RWY07&25)	2038
29	6998	HILL TOP	12° 53' 43.885" N	080° 05' 42.158" E	171.9	166.5	5.4	WITHIN O.H.S.(RWY 12&30) WITHIN O.H.S.(RWY07&25)	13925
30	7026	HILL TOP	12° 58' 34.749" N	080° 09' 58.986" E	136.2	61.5	74.7	WITHIN I.H.S.(RWY 12&30) WITHIN I.H.S.(RWY07&25)	2220
31	7347	BUILDING	13° 00' 25.973" N	080° 09' 04.665" E	24.5	23.0	1.5	WITHIN T.S.(RWY 12&30)	2766
32	7378	BUILDING	12° 58' 56.810" N	080° 08' 48.260" E	24.5	22.9	1.6	WITHIN TAKE-OFF APP.07(RWY07&25)	3232
33	7385	BUILDING	12° 58' 55.880" N	080° 08' 46.300" E	26.6	24.2	2.4	WITHIN TAKE-OFF APP.07(RWY07&25)	3298
34	7400	BUILDING	12° 58' 51.172" N	080° 08' 46.437" E	27.4	25.2	2.2	WITHIN TAKE-OFF APP.07(RWY07&25)	3359
35	7407	BUILDING	12° 58' 51.328" N	080° 08' 44.953" E	30.6	26.0	4.6	WITHIN TAKE-OFF APP.07(RWY07&25)	3397
36	7463	SINTEX TANK ON BUILDING TOP	12° 58' 58.017" N	080° 08' 52.211" E	20.6	20.4	0.2	WITHIN TAKE-OFF APP.07(RWY07&25)	3109
37	7467	BUILDING	12° 59' 03.190" N	080° 08' 53.540" E	23.9	20.2	3.7	WITHIN APP.07(RWY07&25)	3006
38	7473	BUILDING	12° 58' 48.078" N	080° 08' 49.627" E	28.6	25.8	2.8	WITHIN APP.07(RWY07&25)	3321
39	7476	BUILDING	12° 59' 03.010" N	080° 08' 55.600" E	24.6	19.1	5.5	WITHIN APP.07(RWY07&25)	2951
40	7477	BUILDING	12° 59' 02.670" N	080° 08' 55.060" E	23.1	19.5	3.6	WITHIN APP.07(RWY07&25)	2971
41	7717	LIGHTNING ARRESTOR ON BUILDING (BUILDING TOP-	12° 59' 37.461" N	080° 11' 10.077" E	28.0	26.8	1.2	WITHIN APP.30(RWY 12&30)	1367
42	7759	BUILDING	13° 00' 39.760" N	080° 09' 06.420" E	26.2	24.2	2.0	WITHIN APP.12(RWY 12&30)	2951
43	7760	BUILDING	13° 00' 39.022" N	080° 09' 07.558" E	30.6	23.3	7.3	WITHIN APP.12(RWY 12&30)	2910
44	7762	TANK ON BUILDING (BUILDING TOP - 28.4 M)	13° 00' 38.128" N	080° 09' 05.826" E	29.5	24.0	5.5	WITHIN TAKE-OFF APP.12(RWY 12&30)	2936
45	7764	BUILDING	13° 00' 39.620" N	080° 09' 09.460" E	24.3	23.9	0.4	WITHIN T.S.(RWY 12&30)	2876
46	7767	BUILDING	13° 00' 40.220" N	080° 09' 09.840" E	29.9	27.0	2.9	WITHIN T.S.(RWY 12&30)	2878
47	7768	BUILDING	13° 00' 38.560" N	080° 09' 08.380" E	27.5	22.8	4.7	WITHIN APP.12(RWY 12&30)	2882
48	7770	BUILDING	13° 00' 37.090" N	080° 09' 08.220" E	24.5	22.4	2.1	WITHIN TAKE-OFF APP.12(RWY 12&30)	2859
49	7779	BUILDING	13° 00' 32.596" N	080° 09' 03.132" E	25.9	23.9	2.0	WITHIN TAKE-OFF APP.12(RWY 12&30)	2909
50	7795	BUILDING	12° 59' 28.523" N	080° 11' 00.221" E	28.0	24.1	3.9	WITHIN APP.30(RWY 12&30)	1144
51	7802	BUILDING	12° 59' 24.920" N	080° 11' 04.430" E	29.3	27.4	1.9	WITHIN APP.30(RWY 12&30)	1304
52	7803	BUILDING	12° 59' 24.337" N	080° 11' 04.480" E	30.0	27.6	2.4	WITHIN APP.30(RWY 12&30)	1313
53	8033	MAST	12° 58' 45.332" N	080° 08' 36.962" E	33.9	31.8	2.1	WITHIN TAKE-OFF APP.07(RWY07&25)	3696
54	8039	GROUP OF TREES	12° 58' 50.551" N	080° 08' 38.722" E	30.7	29.6	1.0	WITHIN TAKE-OFF APP.07(RWY07&25)	3575
55	8041	GROUP OF TREES	12° 58' 58.491" N	080° 08' 40.014" E	29.3	28.9	0.4	WITHIN APP.07(RWY07&25)	3437
56	8043	GROUP OF TREES	12° 58' 57.135" N	080° 08' 40.406" E	28.4	27.3	1.2	WITHIN TAKE-OFF APP.07(RWY07&25)	3443

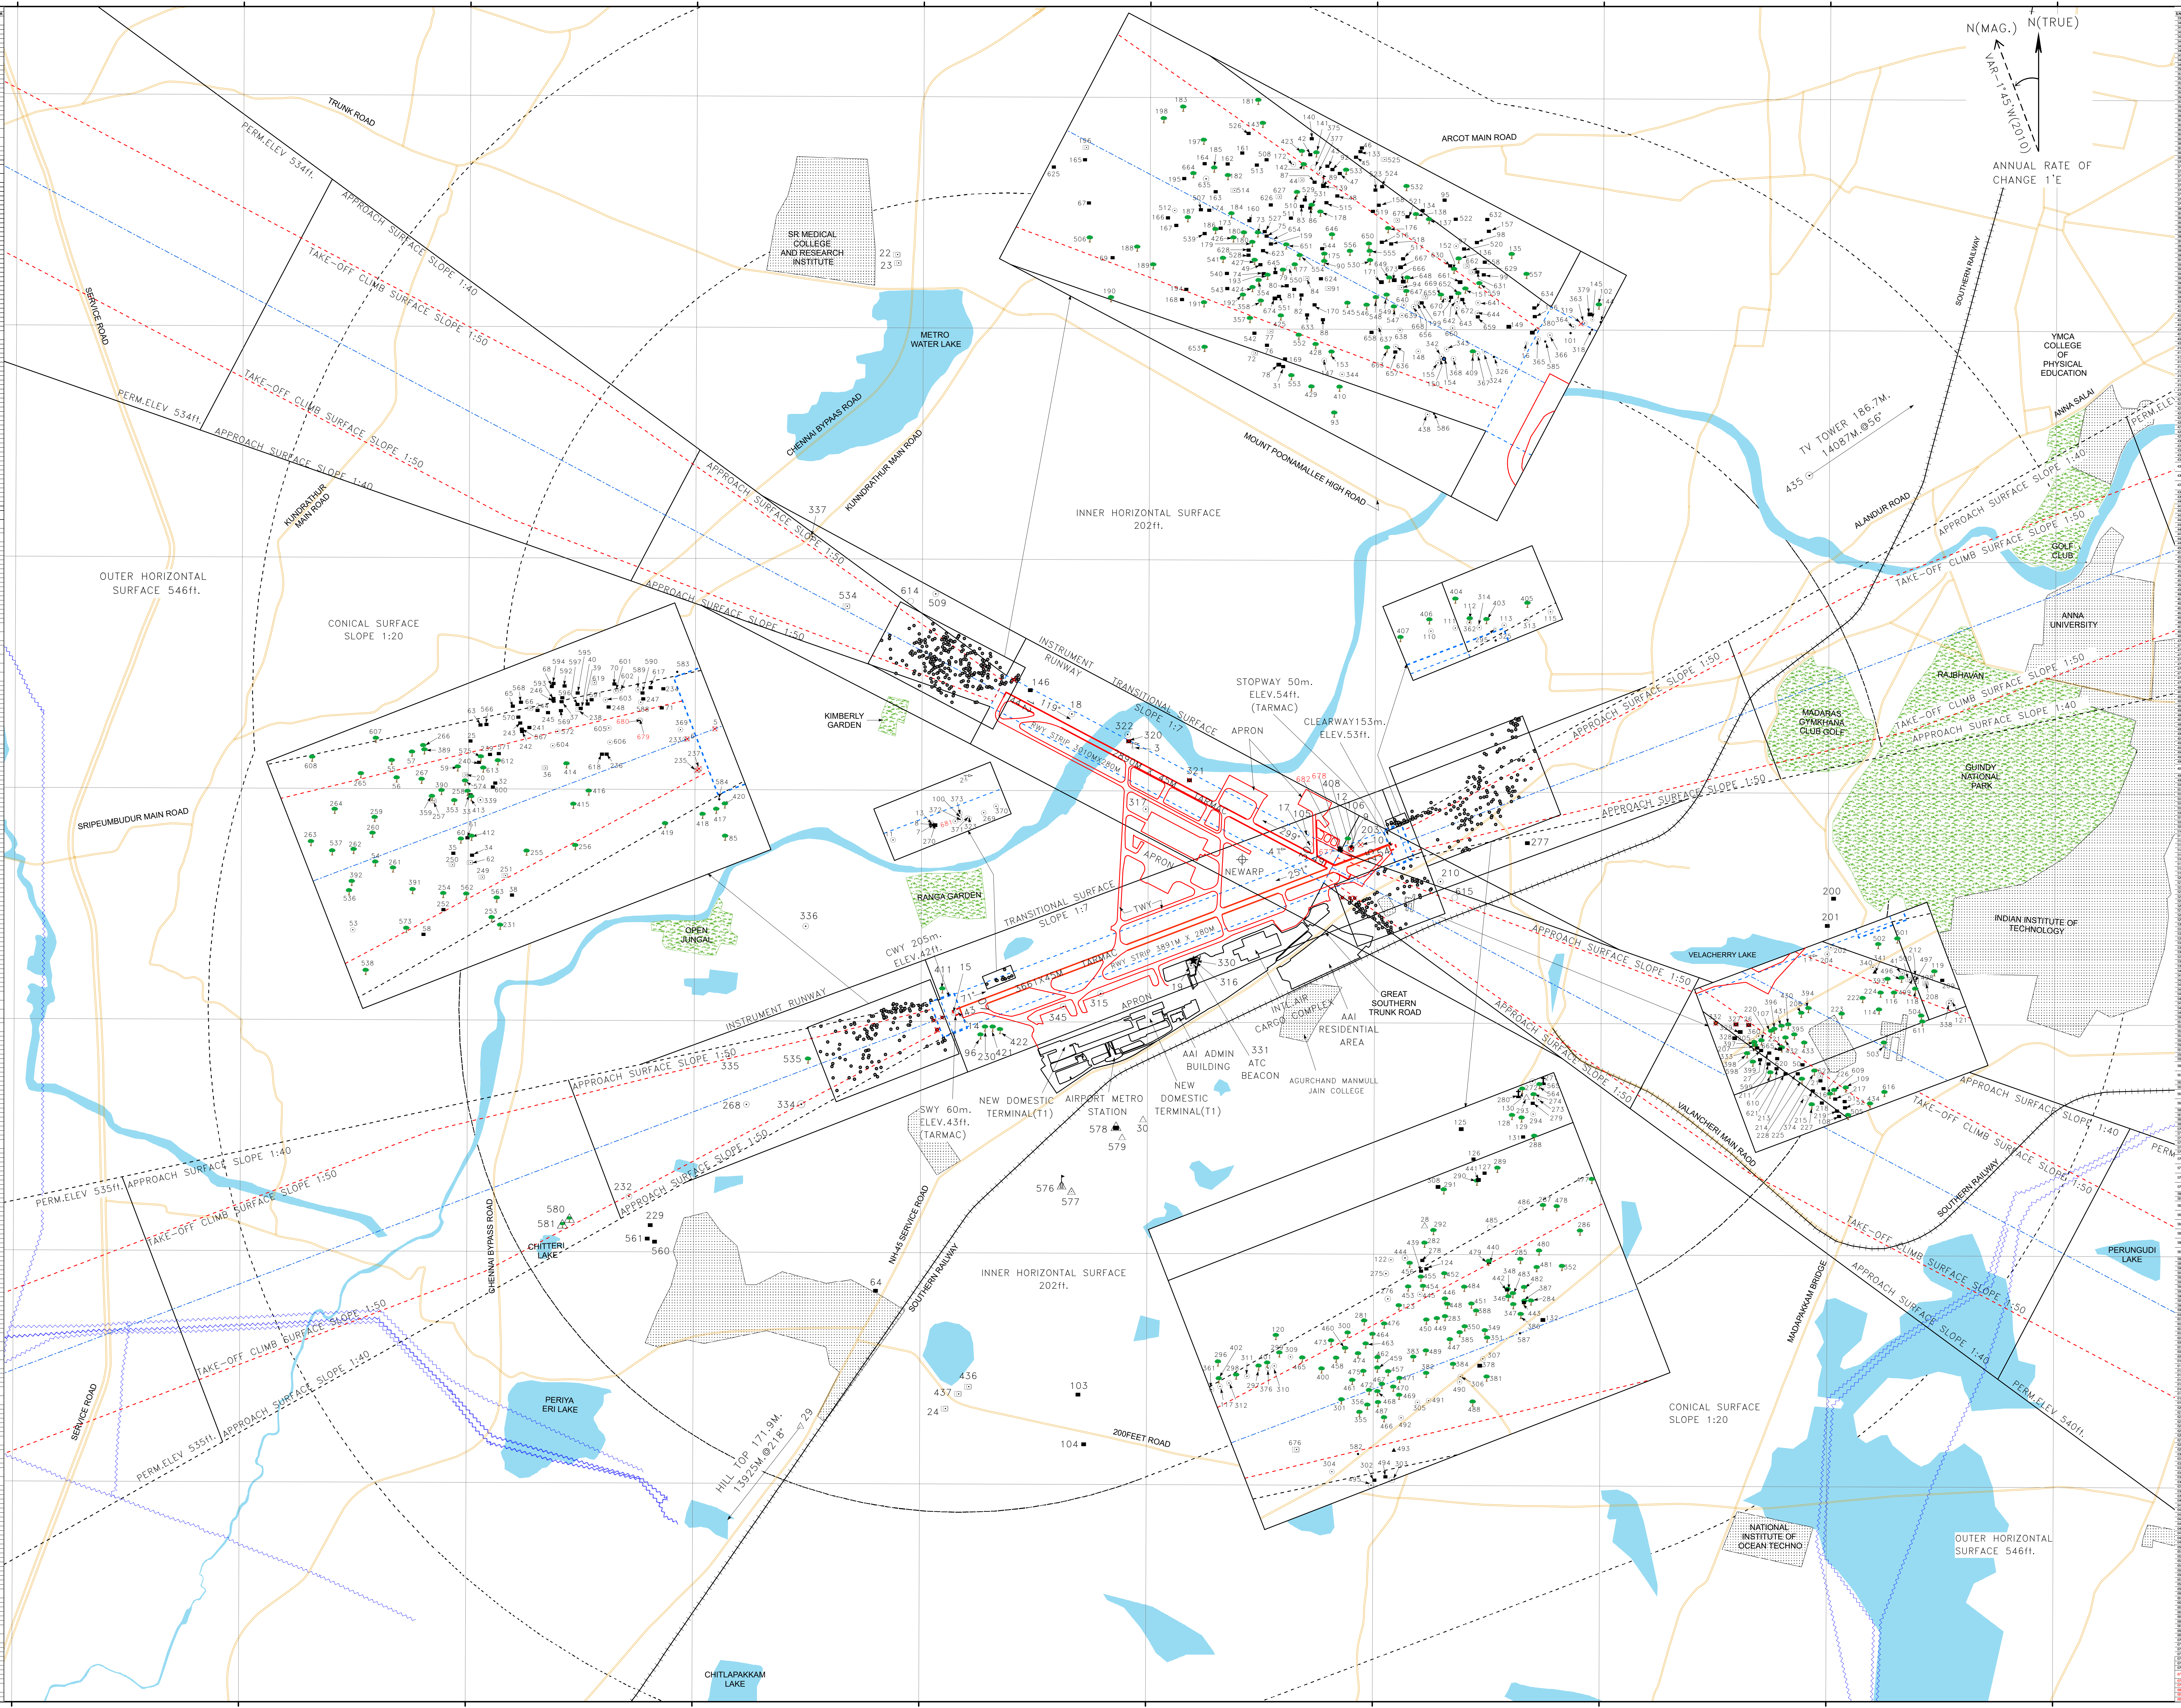
80°4'0"E
80°5'0"E
80°6'0"E
80°7'0"E
80°8'0"E
80°9'0"E
80°10'0"E
80°11'0"E
80°12'0"E
80°13'0"E
80°14'0"E
80°15'0"E
13°3'0"N
13°2'0"N
13°1'0"N
13°0'0"N
12°59'0"N
12°58'0"N
12°57'0"N
N(MAG.)
N(TRUE)
VAR-1°45'W(2010)
ANNUAL RATE OF CHANGE 1'E
TRUNK ROAD
SERVICE ROAD
PERM.ELEV 534ft.
APPROACH SURFACE SLOPE 1:40
TAKE-OFF CLIMB SURFACE SLOPE 1:50
APPROACH SURFACE SLOPE 1:50
SR MEDICAL COLLEGE AND RESEARCH INSTITUTE
METRO WATER LAKE
CHENNAI BYPASS ROAD
KUNDRATHUR MAIN ROAD
ARCOT MAIN ROAD
MOUNT POONAMALLEE HIGH ROAD
INNER HORIZONTAL SURFACE 202ft.
OUTER HORIZONTAL SURFACE 546ft.
CONICAL SURFACE SLOPE 1:20
SOUTHERN RAILWAY
YMCA COLLEGE OF PHYSICAL EDUCATION
ANNA SALAI
TV TOWER 186.7M. 14087M.@56°
ALANDUR ROAD
GOLF CLUB
ANNA UNIVERSITY
RAJBHAVAN
MADARAS GYMKHANA CLUB GOLF
GUINDY NATIONAL PARK
INDIAN INSTITUTE OF TECHNOLOGY
KIMBERLY GARDEN
INSTRUMENT RUNWAY
TRANSITIONAL SURFACE SLOPE 1:7
STOPWAY 50m. ELEV.54ft. (TARMAC)
CLEARWAY153m. ELEV.53ft.
APRON
NEWARP
TWY
RANGA GARDEN
SRIPEUMBUDUR MAIN ROAD
OPEN JUNGAL
CWY 205m. ELEV.42ft.
SWY 60m. ELEV.43ft. (TARMAC)
INT. AIR CARGO COMPLEX
GREAT SOUTHERN TRUNK ROAD
AAI RESIDENTIAL AREA
AAI ADMIN BUILDING
ATC BEACON
NEW DOMESTIC TERMINAL(T1)
AIRPORT METRO STATION
AGURCHAND MANMULL JAIN COLLEGE
VELACHERRY LAKE
VELANCHERI MAIN ROAD
PERM.ELEV 535ft.
PERM.ELEV 540ft.
CHITTERI LAKE
CHENNAI BYPASS ROAD
NH45 SERVICE ROAD
200FEET ROAD
PERIYA ERI LAKE
HILL TOP 171.9M. 13925M.@218°
PERUNGUDI LAKE
MADIPAKKAM BRIDGE
NATIONAL INSTITUTE OF OCEAN TECHNO
CHITLAPAKKAM LAKE

OBST. TABLE FOR RWY 07&25 AND 12&30

S.NO.	UID	FEATURE	LATITUDE	LONGITUDE	TOP.ELEV.IN M.	PERM.ELEV. IN M.	OBST. IN M.	REMARKS	DIST FROM ARP IN M.
339	16192	CELL PHONE MAST	12° 58' 55.514" N	080° 08' 47.089" E	26.8	23.9	2.9	WITHIN TAKE-OFF APP.07(RWY07&25)	3281
340	16268	LIGHT POLE	12° 59' 38.070" N	080° 11' 07.220" E	26.1	25.1	1.0	WITHIN APP.30(RWY 12&30)	1280
341	16269	BOARD	12° 59' 37.660" N	080° 11' 07.400" E	26.0	25.3	0.7	WITHIN APP.30(RWY 12&30)	1286
342	16460	ELECTRIC POLE	13° 00' 26.674" N	080° 09' 15.162" E	19.6	15.8	3.8	WITHIN TAKE-OFF APP.12(RWY 12&30)	2505
343	16461	ELECTRIC POLE	13° 00' 27.137" N	080° 09' 15.509" E	20.3	15.7	4.6	WITHIN TAKE-OFF APP.12(RWY 12&30)	2504
344	16462	ELECTRIC POLE	13° 00' 25.494" N	080° 09' 08.580" E	20.0	18.9	1.1	WITHIN APP.12(RWY 12&30)	2656
345	16627	FLOOD LIGHT	12° 59' 04.078" N	080° 09' 37.782" E	31.5	30.2	1.2	WITHIN T.S.(RWY07&25)	1845
346	16790	GROUP OF TREE	13° 00' 00.620" N	080° 11' 35.170" E	44.0	34.3	9.7	WITHIN TAKE-OFF APP.25(RWY07&25)	2188
347	16791	GROUP OF TREE	12° 59' 59.950" N	080° 11' 35.610" E	41.2	34.4	6.8	WITHIN TAKE-OFF APP.25(RWY07&25)	2196
348	16792	GROUP OF TREES	13° 00' 01.261" N	080° 11' 35.110" E	39.5	34.4	5.1	WITHIN TAKE-OFF APP.25(RWY07&25)	2191
349	16795	GROUP OF TREE	12° 59' 57.720" N	080° 11' 33.140" E	38.2	32.5	5.7	WITHIN TAKE-OFF APP.25(RWY07&25)	2107
350	16796	GROUP OF TREE	12° 59' 58.060" N	080° 11' 31.390" E	36.7	31.6	5.1	WITHIN TAKE-OFF APP.25(RWY07&25)	2058
351	16797	GROUP OF TREE	12° 59' 57.110" N	080° 11' 33.330" E	39.7	32.5	7.2	WITHIN TAKE-OFF APP.25(RWY07&25)	2109
352	16798	GROUP OF TREES	13° 00' 03.230" N	080° 11' 39.825" E	40.7	37.5	3.2	WITHIN TAKE-OFF APP.25(RWY07&25)	2344
353	16808	GROUP OF TREES	12° 58' 55.360" N	080° 08' 45.000" E	29.2	25.1	4.1	WITHIN TAKE-OFF APP.07(RWY07&25)	3340
354	16812	GROUP OF TREES	13° 00' 31.501" N	080° 09' 03.013" E	32.9	23.6	9.3	WITHIN TAKE-OFF APP.12(RWY 12&30)	2894
355	16816	GROUP OF TREES	12° 59' 50.716" N	080° 11' 22.250" E	29.0	24.8	4.1	WITHIN TAKE-OFF APP.25(RWY07&25)	1745
356	16818	GROUP OF TREE	12° 59' 51.353" N	080° 11' 22.933" E	30.3	25.4	4.9	WITHIN TAKE-OFF APP.25(RWY07&25)	1768
357	16821	GROUP OF TREES	13° 00' 29.040" N	080° 09' 02.450" E	31.8	23.2	8.6	WITHIN APP.12(RWY 12&30)	2870
358	16822	GROUP OF TREES	13° 00' 30.170" N	080° 09' 03.160" E	29.5	23.2	6.3	WITHIN TAKE-OFF APP.12(RWY 12&30)	2869
359	16823	GROUP OF TREES	12° 58' 55.680" N	080° 08' 43.220" E	27.1	26.0	1.1	WITHIN TAKE-OFF APP.07(RWY07&25)	3384
360	16922	LIGHT POST	12° 59' 31.315" N	080° 10' 55.839" E	24.7	21.0	3.7	WITHIN APP.30(RWY 12&30)	990
361	17315	LIGHT POST	12° 59' 52.720" N	080° 11' 09.386" E	24.3	18.9	5.4	WITHIN APP.25(RWY07&25)	1375
362	17330	LIGHT POST	12° 59' 52.040" N	080° 11' 05.810" E	31.4	20.5	10.9	WITHIN T.S.(RWY07&25)	1266
363	17506	LIGHT POST	13° 00' 28.890" N	080° 09' 24.660" E	15.6	13.2	2.4	WITHIN T.S.(RWY 12&30)	2312
364	17507	LIGHT POST	13° 00' 28.620" N	080° 09' 23.910" E	15.7	12.8	2.9	WITHIN STRIP(RWY 12&30)	2325
365	17511	LIGHT POST	13° 00' 27.830" N	080° 09' 21.580" E	15.3	12.8	2.5	WITHIN STRIP(RWY 12&30)	2366
366	17512	LIGHT POST	13° 00' 28.100" N	080° 09' 22.360" E	15.2	12.8	2.4	WITHIN STRIP(RWY 12&30)	2352
367	17515	LIGHT POST	13° 00' 26.860" N	080° 09' 17.570" E	15.5	14.5	1.0	WITHIN TAKE-OFF APP.12(RWY 12&30)	2448
368	17517	LIGHT POST	13° 00' 26.540" N	080° 09' 15.960" E	15.7	15.3	0.4	WITHIN TAKE-OFF APP.12(RWY 12&30)	2483
369	17701	LIGHT POLE	12° 59' 01.040" N	080° 09' 03.000" E	15.7	13.7	2.0	WITHIN TAKE-OFF APP.07(RWY07&25)	2777
370	18703	MET INSTRUMENT	12° 59' 11.946" N	080° 09' 24.159" E	14.9	13.2	1.7	WITHIN STRIP(RWY07&25)	2057
371	18704	MET INSTRUMENT	12° 59' 11.201" N	080° 09' 22.318" E	15.2	13.1	2.1	WITHIN STRIP(RWY07&25)	2116
372	18705	CIWS ANTENNA	12° 59' 11.101" N	080° 09' 21.856" E	23.2	13.1	10.1	WITHIN STRIP(RWY07&25)	2130
373	18706	LIGHTNING ARRESTOR	12° 59' 11.498" N	080° 09' 21.844" E	18.9	13.1	5.8	WITHIN STRIP(RWY07&25)	2125
374	18710	OVER HEAD WATER TANK	12° 59' 25.280" N	080° 11' 00.490" E	37.9	29.1	8.8	WITHIN T.S.(RWY 12&30)	1192
375	18711	OVER HEAD WATER TANK	13° 00' 38.950" N	080° 09' 06.620" E	25.5	23.8	1.7	WITHIN APP.12(RWY 12&30)	2932
376	18714	LIGHT POST	12° 59' 54.550" N	080° 11' 14.300" E	25.7	22.1	3.6	WITHIN APP.25(RWY07&25)	1532
377	18778	POLE	13° 00' 38.580" N	080° 09' 07.030" E	31.7	23.5	8.2	WITHIN APP.12(RWY 12&30)	2915
378	19084	SHED ON METRO BRIDGE TOP	12° 59' 54.820" N	080° 11' 32.710" E	32.3	31.6	0.7	WITHIN TAKE-OFF APP.25(RWY07&25)	2076
379	19258	SHED TOP	13° 00' 29.447" N	080° 09' 25.011" E	19.9	16.1	3.8	WITHIN T.S.(RWY 12&30)	2314
380	19259	SHED TOP	13° 00' 28.250" N	080° 09' 21.190" E	20.5	13.0	7.5	WITHIN TAKE-OFF APP.12(RWY 12&30)	2383
381	19375	TREE	12° 59' 53.780" N	080° 11' 33.310" E	33.0	31.7	1.3	WITHIN TAKE-OFF APP.25(RWY07&25)	2088
382	19377	TREE	12° 59' 54.080" N	080° 11' 28.040" E	40.9	28.8	12.1	WITHIN TAKE-OFF APP.25(RWY07&25)	1934
383	19379	TREE	12° 59' 55.450" N	080° 11' 26.920" E	36.6	28.5	8.1	WITHIN TAKE-OFF APP.25(RWY07&25)	1909
384	19380	TREE	12° 59' 54.850" N	080° 11' 30.390" E	32.5	30.3	2.2	WITHIN TAKE-OFF APP.25(RWY07&25)	2008
385	19381	TREE	12° 59' 57.550" N	080° 11' 30.950" E	38.1	31.2	6.9	WITHIN TAKE-OFF APP.25(RWY07&25)	2042
386	19386	TREE	12° 59' 59.130" N	080° 11' 36.260" E	40.9	34.6	6.3	WITHIN TAKE-OFF APP.25(RWY07&25)	2209
387	19387	TREE	13° 00' 00.240" N	080° 11' 36.580" E	37.3	35.0	2.3	WITHIN TAKE-OFF APP.25(RWY07&25)	2226
388	19388	GROUP OF TREE	12° 59' 59.391" N	080° 11' 32.374" E	43.7	32.4	11.3	WITHIN TAKE-OFF APP.25(RWY07&25)	2097
671	22420	BUILDING	13° 00' 30.540" N	080° 09' 15.790" E	19.8	16.5	3.3	WITHIN TAKE-OFF APP.12(RWY 12&30)	2556
672	22421	BUILDING	13° 00' 30.380" N	080° 09' 16.530" E	19.9	16.1	3.8	WITHIN TAKE-OFF APP.12(RWY 12&30)	2535
673	22422	RESIDENTIAL BUILDING	13° 00' 31.630" N	080° 09' 12.020" E	20.2	18.8	1.4	WITHIN TAKE-OFF APP.12(RWY 12&30)	2669
674	22423	RESIDENTIAL BUILDING (WATER TANK TOP)	13° 00' 30.420" N	080° 09' 04.110" E	23.9	22.7	1.2	WITHIN TAKE-OFF APP.12(RWY 12&30)	2849
675	22427	CELLPHONE MAST ON BUILDING	13° 00' 35.530" N	080° 09' 12.170" E	31.9	19.9	12.0	WITHIN APP.12(RWY 12&30)	2735
676	22433	ANTENNA ON LLZ HUT	12° 59' 47.622" N	080° 11' 16.730" E	21.6	21.1	0.5	WITHIN TAKE-OFF APP.25(RWY07&25)	1568
677	4038	GP MAIN ANTENNA L/A TOP (LIGHTED TOP- 31.2 M.)	12° 59' 44.933" N	080° 10' 51.232" E	31.4	15.4	16.0	WITHIN RWY STRIP(07&25)	795
678	4039	GP DME ANTENNA L/A TOP (LIGHTED TOP - 20.6M.)	12° 59' 45.019" N	080° 10' 51.174" E	21.1	15.4	5.7	WITHIN RWY STRIP(07&25)	794
679	10902	MLAT ANTENNA TOP	12° 59' 01.679" N	080° 08' 59.457" E	19.5	18.4	1.1	WITHIN APP. 07(RWY07&25)	2863
680	10903	LIGHTNING ARRESTOR ON DISH	12° 59' 01.687" N	080° 08' 59.436" E	20.1	18.4	1.7	WITHIN APP. 07(RWY07&25)	2864
681	18951	DCWS ANTENNA TOP	12° 59' 11.036" N	080° 9' 21.663" E	22.7	13.2	9.5	WITHIN RWY STRIP(07&25)	2136
682	22713	GP HUT	12° 59' 45.037" N	080° 10' 50.924" E	18.5	15.5	3.0	WITHIN RWY STRIP(07&25)	786

LEGEND

AERODROME REFERENCE POINT 12°59'42.36"N 080°10'24.97"E	⊕
ROAD	
RAILTRACK	
HT LINE	
BUILT-UP AREA	▨
PARK OR GARDEN	🟩
WATER BODIES	🟦

ORDER OF ACCURACY

TAKE-OFF AND APPROACH AREAS	
HORIZONTAL	REMARK
5M	AT POINT OF ORIGIN INCREASING AT A RATE OF 1 PER 500.
VERTICAL	REMARK
0.5M	IN THE FIRST 300M AND INCREASING AT A RATE OF 1 PER 1000.
OTHER AREAS	
HORIZONTAL	REMARK
5M	WITHIN 5000M OF THE ARP AND 12M BEYOND THAT AREA.
VERTICAL	REMARK
1M	WITHIN 1500M OF THE ARP INCREASING AT A RATE OF 1 PER 1000.

SCALE 1:20,000

METRES
480 0 480 960 1440 1920 2400
1500 0 1500 3000 4500 6000 7500
FEET

NOTE :

1.OBSTACLES SHOWN ARE THOSE WHICH PENETRATE THE SURFACES SPECIFIED IN ANNEX 14, VOL-1, CHAPTER-4 & GSR.
2.TORA FOR RWY 07 IS 3661M.
TORA FOR RWY 25 IS 3661M
TORA FOR RWY 12 IS 2890M
TORA FOR RWY 30 IS 2680M.
3.ALL OBSTACLES ARE SHOWN IN THE CHART BASED ON AERONAUTICAL SURVEY FEBRUARY 2022.
4.TOPOGRAPHIC FEATURES SOURCE- WORLD TOPO MAP, ESRI

AMENDMENT RECORD

NO.	DATE	ENTERED BY

AERONAUTICAL INFORMATION UPTO: OCT.2023

COMPILED BY:CARTO, AIRPORTS AUTHORITY OF INDIA

AAI DRG.NO.- 30/CHENNAI/2023(CARTO)
(UPDATED 24-07-25)